

Date: Friday, 26/01/2007 1:59:10 PM  
User: Linda Lacelle

# Process Sheet

<b>Customer</b> : CU-DAR001 Dart Helicopters Services	<b>Drawing Name</b> : 206/OH-58 SADDLE, OUTBOARD, LEFT SIDE
<b>Job Number</b> : 30484	
<b>Estimate Number</b> : 10831	
<b>P.O. Number</b> : N/A	<b>Part Number</b> : D29321
<b>This Issue</b> : 26/01/2007 <b>S.O. No.</b> : N/A	<b>Drawing Number</b> : D2932 UNDER REVIEW
<b>Prsht Rev.</b> : NC	<b>Project Number</b> : N/A
<b>First Issue</b> : N/A <b>Type</b> : MACHINED PARTS	<b>Drawing Revision</b> : B
<b>Previous Run</b> : 30280	<b>Material</b> : N/A
<b>Written By</b> : _____	<b>Due Date</b> : 12/02/2007
<b>Checked &amp; Approved By</b> : _____	<b>Qty:</b> 4 <b>Um:</b> Each
<b>Comment</b> : Est: B 00.06.25 New DWG rev, (mpp 2069) EC	

## Additional Product

Job Number:



<b>Seq. #:</b>	<b>Machine Or Operation:</b>	<b>Description :</b>
----------------	------------------------------	----------------------

1.0	D6101003	7075-T7351 2X6.25X7.875
-----	----------	-------------------------



**Comment:** Qty.: 1.0000 Each(s)/Unit Total: 4.0000 Each(s)

7075-T7351 2X6.25X7.875

Issue material from stock:

7075-T7351 Cut Size 2.0 x 6.25 X 7.880 Grain Along Long 7.88 Length

Batch No: B25349

SD 07.02.01

(4)

2.0	HAAS1	HAAS CNC VERTICAL MACHINING #1
-----	-------	--------------------------------



**Comment:** HAAS CNC VERTICAL MACHINING #1

Program part number and batch number.

1-Inspect part number and batch number are programmed correctly.

2-Machine Step No 1 of Folio and visually inspect as per dwg D2932 & attached Dimension Sheet

3-Machine Step No 2 of Folio and visually inspect as per dwg D2932 & attached Dimension Sheet

4-Machine Step No 3 of Folio and visually inspect as per dwg D2932 & attached Dimension Sheet

5-Deburr & TUMBLE

SD 07.02.02

(4)

3.0	MILLING CONV.	CONVENTIONAL MILLING MACHINE
-----	---------------	------------------------------



**Comment:** CONVENTIONAL MILLING MACHINE

Machine Keyway and inspect per attached dimension sheet

MB 07.02.03

(4)

4.0	QC1	INSPECT ALL DIM TO DIM SHEET
-----	-----	------------------------------



**Comment:** INSPECT ALL DIM TO DIM SHEET

SD 07.02.02

(4)

# Dart Aerospace Ltd

W/O:		WORK ORDER CHANGES					
DATE	STEP	PROCEDURE CHANGE	By	Date	Qty	Approval Chief Eng / Prod Mgr	Approval QC Inspector
07.01.26	2	TOOL RD FOR FLANGE POCKETS SHOULD BE R0.188				CP 07.01.26 per QSI 042	

Part No: \_\_\_\_\_ PAR #: \_\_\_\_\_ Fault Category: \_\_\_\_\_ NCR: Yes ☒ No ☐ DQA: ☒ Date: 07/02/13

QA: N/C Closed: \_\_\_\_\_ Date: \_\_\_\_\_

NCR:		WORK ORDER NON-CONFORMANCE (NCR)						
DATE	STEP	Description of NC Section A	Corrective Action Section B			Verification Section C	Approval Chief Eng	Approval QC Inspector
			Initial Chief Eng	Action Description Chief Eng	Sign & Date			

NOTE: Date & initial all entries

Date: Friday, 26/01/2007 1:59:10 PM  
User: Linda Lacelle

## Process Sheet

Customer: CU-DAR001 Dart Helicopters Services

Drawing Name: 206/OH-58 SADDLE, OUTBOARD, LEFT SIDE

Job Number: 30484

Part Number: D29321

Job Number:



Seq. #: Machine Or Operation: Description :

5.0 QC8 SECOND CHECK



Comment: SECOND CHECK

mk 07/02/05

(4)

6.0 HAND FINISHING1 HAND FINISHING RESOURCE #1



Comment: HAND FINISHING RESOURCE #1

Acid etch and Alodine as per QSI 005 4.1

FL

07/02/05

(4)

7.0 POWDER COATING POWDER COATING



Comment: POWDER COATING

Powder Coat White Gloss (Ref: 4.3.5.1) as per QSI 005 4.3

M/103141

ATTN: Paint Ipc grey

m-h / 8

07/02/09 x4

8.0 QC3 INSPECT POWDER COAT/CHEMICAL CONVERSION



Comment: INSPECT POWDER COAT

07/02/12

(4)

9.0 PACKAGING 1 PACKAGING RESOURCE #1



Comment: PACKAGING RESOURCE #1

Identify and Stock

Location:

57479

07/04/12

(4)

3 WHITE  
1 GREY

10.0 QC21 FINAL INSPECTION/W/O RELEASE



Comment: FINAL INSPECTION/W/O RELEASE

07/02/13

(4)

Job Completion



U 07/02/12

W/O:		WORK ORDER CHANGES					
DATE	STEP	PROCEDURE CHANGE	By	Date	Qty	Approval Chief Eng / Prod Mgr	Approval QC Inspector

Part No: \_\_\_\_\_ PAR #: \_\_\_\_\_ Fault Category: \_\_\_\_\_ NCR: Yes No DQA: \_\_\_\_\_ Date: \_\_\_\_\_

QA: N/C Closed: \_\_\_\_\_ Date: \_\_\_\_\_

NCR:		WORK ORDER NON-CONFORMANCE (NCR)						
DATE	STEP	Description of NC Section A	Corrective Action Section B			Verification Section C	Approval Chief Eng	Approval QC Inspector
			Initial Chief Eng	Action Description Chief Eng	Sign & Date			

**NOTE:** Date & initial all entries

<b>DART AEROSPACE LTD</b>	<b>Work Order:</b> 30484
<b>Description:</b> 206 Saddle, Outboard, Left side	<b>Part Number:</b> D2932-1
<b>Inspection Dwg:</b> D2932 Rev. B	<b>Page 1 of 1</b>

Inspect dimensions highlighted on inspection sheet drawing D2932 Rev. B and record below:

				Recorded Actual Dimensions					
Dim	Min	Max	Go/No Go Gauge	1	2	3	4	By	Date
A	0.100	0.140		.121	.121	.121	.121		
B	0.100	0.140		.121	.122	.121	.122		
C	0.100	0.140		.120	.127	.122	.124		
D	0.210	0.230		.221	.219	.220	.219		
E	1.245	1.255		1.258	1.258	1.258	1.258		
F	1.245	1.255		1.258	1.258	1.258	1.258		
G	2.495	2.505		2.500	2.500	2.500	2.500		
H	0.510	0.515		.510	.510	.510	.510		
I	1.572	1.582		1.577	1.577	1.577	1.577		
J	2.495	2.505		2.500	2.500	2.500	2.500		
K	0.257	0.262	<del>DT8683</del>	.258	.258	.258	.258		
L	0.312	0.317	<del>DT8686</del>	.314	.314	.314	.314		
M	0.235	0.240		.238	.238	.238	.238		
N	0.100	0.140		.121	.119	.119	.120		
O	0.540	0.560		.548	.549	.548	.548		
P	0.490	0.510		.500	.494	.495	.494		
Q	3.715	3.725		3.720	3.720	3.720	3.720		
R	2.470	2.510		2.495	2.495	2.495	2.495		
S	0.240	0.270		.249	.250	.249	.251		
T	0.100	0.180		.140	.140	.140	.140		
U	1.625	1.635		1.630	1.630	1.630	1.630		
V	1.362	1.372		1.367	1.367	1.367	1.367		
W	0.316	0.321	<del>DT8690</del>	.320	.320	.320	.320		
X	1.125	1.145		1.134	1.133	1.133	1.133		
Y	1.565	1.585		1.573	1.573	1.573	1.573		
Z									
AA									
AB									
AC									
AD									
AE									
AF									
AG									
AH									
Accept/Reject									

Measured by: <u>SD</u>	Audited by: <u>ml</u>
Date: <u>07.02.01</u>	Date: <u>07/02/05</u>

Rev	Date	Change	Revised by	Approved
A		New Issue	RF	
B	02.12.12	Re-format; Added Dim. X-Y, DT8683, DT8686, DT8690	KJ/RF	#





W/O:		WORK ORDER CHANGES					
DATE	STEP	PROCEDURE CHANGE	By	Date	Qty	Approval Chief Eng / Prod Mgr	Approval QC Inspector

Part No: \_\_\_\_\_ PAR #: \_\_\_\_\_ Fault Category: \_\_\_\_\_ NCR: Yes No DQA: \_\_\_\_\_ Date: \_\_\_\_\_

QA: N/C Closed: \_\_\_\_\_ Date: \_\_\_\_\_

NCR:		WORK ORDER NON-CONFORMANCE (NCR)						
DATE	STEP	Description of NC Section A	Corrective Action Section B			Verification Section C	Approval Chief Eng	Approval QC Inspector
			Initial Chief Eng	Action Description Chief Eng	Sign & Date			

NOTE: Date & initial all entries

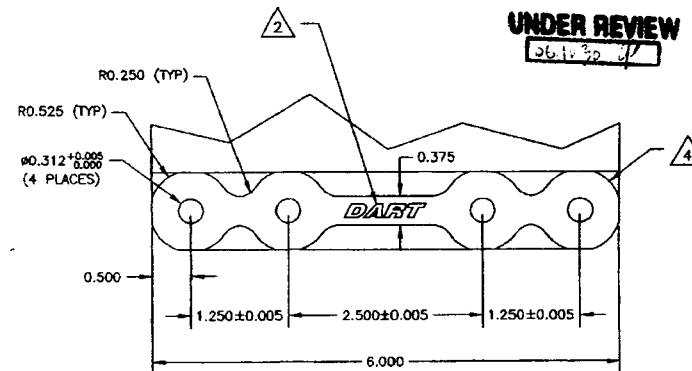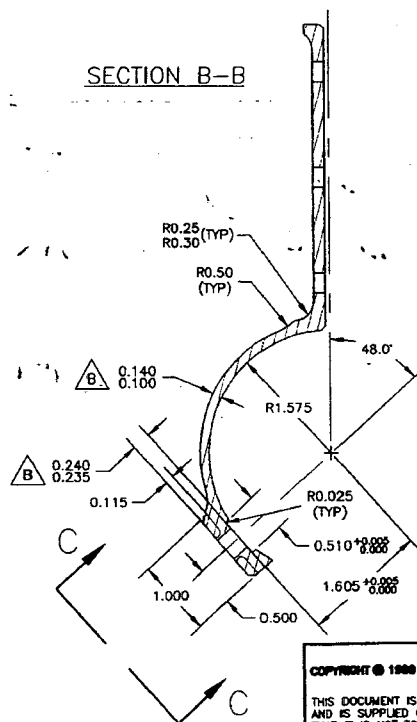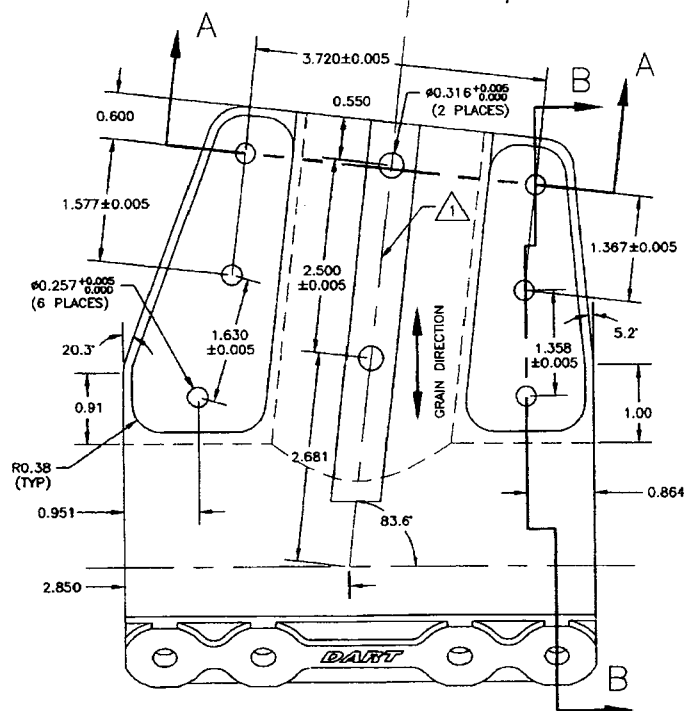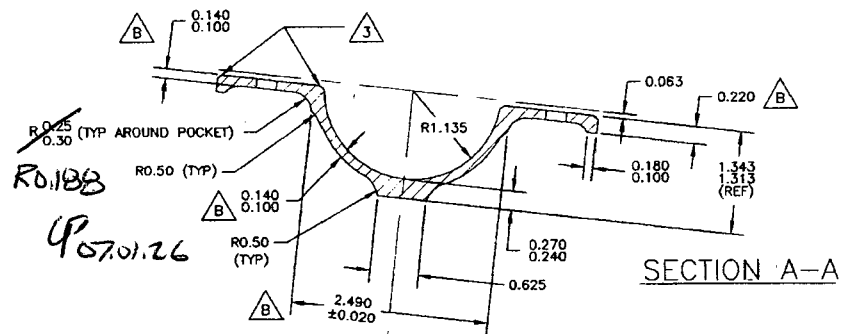

D2932-1 LH SADDLE (SHOWN)  
D2932-2 RH SADDLE (OPPOSITE)

MATERIAL: 7075-T7351 (QC-A-250/12)  
FINISH: CHEMICAL CONVERSION COAT PER DART QSI 005 4.1  
POWDER COAT GLOSS WHITE (REF 4.3.5.1) PER  
DART QSI 005 4.3  
BREAK ALL SHARP EDGES 0.010 TO 0.020  
TOLERANCES ARE PER DART QSI 018 UNLESS OTHERWISE NOTED.

- 1 ENGRAVE PART AND BATCH NUMBER IN THIS AREA 0.010 TO 0.015 DEEP
- 2 ENGRAVE DART LOGO TO MAX DEPTH OF 0.005 WITH MIN RAD 0.250
- 3 CHAMFER 0.050" x 45° AROUND THIS SURFACE (TYPICAL 2 PLACES)
- 4 CHAMFER 0.050" x 45°

RELEASED

B	00.05.29	CHANGED GEOMETRY AND MATERIAL
A	99.10.29	NEW ISSUE
DESIGN	DRAWN BY	DART DART AEROSPACE USA, INC.
CHECKED	APPROVED	D2932
DATE	00.05.29	SADDLE OUTSIDE

COPYRIGHT © 1988 BY DART AEROSPACE USA, INC.

THIS DOCUMENT IS PRIVATE AND CONFIDENTIAL AND IS SUPPLIED ON THE EXPRESS CONDITION THAT IT IS NOT TO BE USED FOR ANY PURPOSE OR COPIED OR COMMUNICATED TO ANY OTHER PERSON WITHOUT WRITTEN PERMISSION FROM DART AEROSPACE USA, INC.



REV. B  
SHEET 1 OF 1  
SCALE  
2:3

W/O:		WORK ORDER CHANGES					
DATE	STEP	PROCEDURE CHANGE	By	Date	Qty	Approval Chief Eng / Prod Mgr	Approval QC Inspector

Part No: \_\_\_\_\_ PAR #: \_\_\_\_\_ Fault Category: \_\_\_\_\_ NCR: Yes No DQA: \_\_\_\_\_ Date: \_\_\_\_\_

QA: N/C Closed: \_\_\_\_\_ Date: \_\_\_\_\_

NCR:		WORK ORDER NON-CONFORMANCE (NCR)						
DATE	STEP	Description of NC Section A	Corrective Action Section B			Verification Section C	Approval Chief Eng	Approval QC Inspector
			Initial Chief Eng	Action Description Chief Eng	Sign & Date			

NOTE: Date & initial all entries



**Chris Provencal**

---

**From:** David Shepherd [dshepherd@dartaero.com]  
**Sent:** October 19, 2006 3:31 PM  
**To:** 'S Shahbazian'  
**Cc:** 'Provencal, Chris'; 'Charbonneau, Eric'  
**Subject:** RE: Radius dimension on the saddle  
**Importance:** High

Change the drawings. I guess we will also change the 0.313 crosstube hole dimensions as well.  
See D2661 to D2668 as well as D2932 to D2933.

David

---

**From:** S Shahbazian [mailto:sshahbazian@dartaero.com]  
**Sent:** Thursday, October 19, 2006 1:16 PM  
**To:** Shepherd, David  
**Cc:** Provencal, Chris; Charbonneau, Eric  
**Subject:** Radius dimension on the saddle

Dave,  
On attach saddle drawing, according to Eric the marked-up radius that reads 0.30 and 0.25, should be 0.188 since the tooling has been changed long time ago, and apparently they have been machining those radiuses to 0.188 for a while. Do you see a problem with that? if not I will go ahead and change the drawing to reflect the changes.

Serge

--  
No virus found in this incoming message.  
Checked by AVG Free Edition.  
Version: 7.1.408 / Virus Database: 268.13.7/488 - Release Date: 10/19/2006

--  
No virus found in this outgoing message.  
Checked by AVG Free Edition.  
Version: 7.1.408 / Virus Database: 268.13.7/488 - Release Date: 10/19/2006

26/01/2007